


A-105  
C. Model  
New Conduit  
E-2

DRAWING NUMBER

DRAWING NUMBER

DRAWING NUMBER

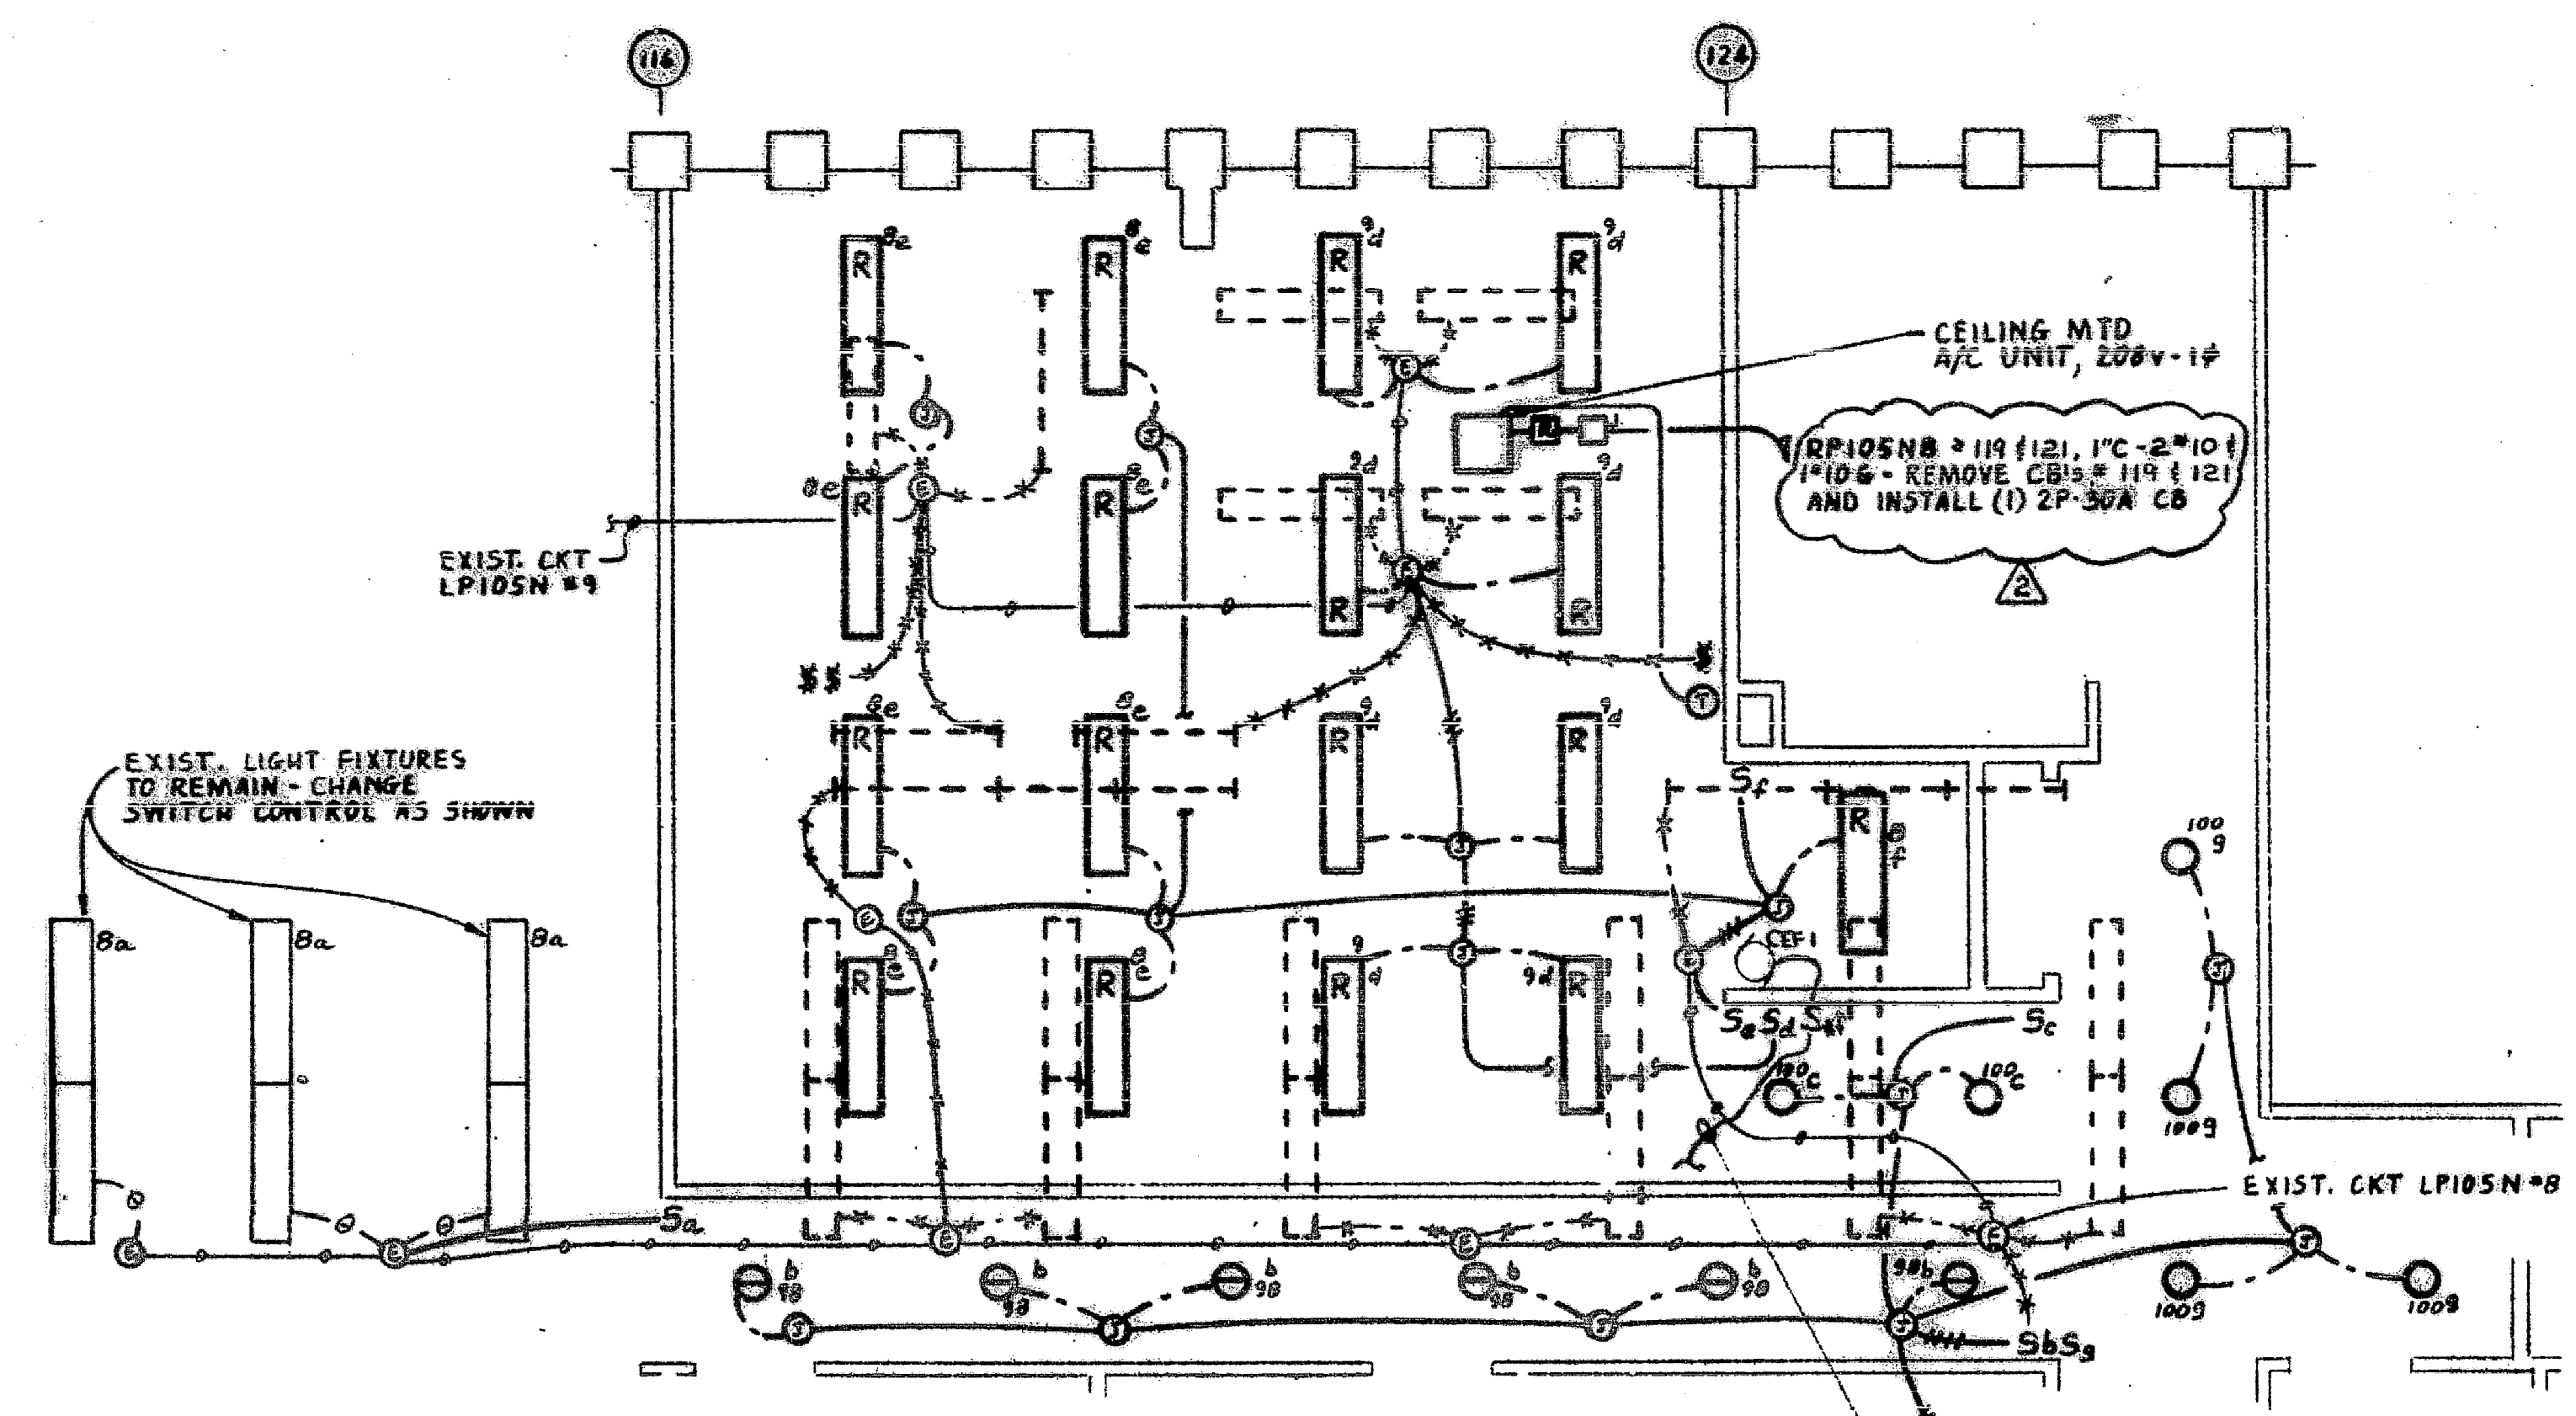


LEGEND

- EXISTING STRIP LIGHT TO BE REMOVED
- EXISTING 1x4' FLUORESCENT FIXTURE TO REMAIN
- EXISTING 1x4' FLUORESCENT FIXTURE TO BE RELOCATED
- RELOCATED 1x4' FLUORESCENT FIXTURE
- SEE DWG 105F #4 FOR FIXTURE SCHEDULE AND SPECS.
- RECESSED WALL WASHER - 100W
- RECESSED DOWN LIGHT - 100W
- EXISTING JUNCTION BOX TO REMAIN
- JUNCTION BOX
- EXISTING SWITCH TO BE REMOVED
- SINGLE POLE TOGGLE SWITCH 20A-277V, WALL MTD 50" APP HUBBELL #221-GRAY, OR 15A-125V #101-GRAY, LETTER DENOTES CONTROL.
- EXISTING CONDUIT & WIRING TO REMAIN
- REMOVE EXISTING CONDUIT & WIRING
- RIGID STEEL CONDUIT (U.L. STD #6) RUN CONCEALED
- EXISTING FLEXIBLE CONDUIT & CABLE CONNECTION TO REMAIN
- REMOVE EXISTING FLEXIBLE CONDUIT & CABLE CONNECTION
- FLEXIBLE CONDUIT & CABLE CONNECTION (U.L. STD #316)
- WOMERUN TO PANEL INDICATED. MINIMUM SIZE 1" CBT.
- 2"14 TEFLON SMOKE DETECTION WIRING
- FLEXIBLE CONDUIT - MINIMUM SIZE 3/4"
- SMOKE DETECTOR - "U" DENOTES UNDERFLOOR MOUNTED
- THERMOSTAT
- KEY OPERATED SWITCH WALL MOUNTED 50" APP, 15A-125V HUBBELL #101-L
- EXISTING RECEPTACLE TO REMAIN
- REMOVE EXISTING RECEPTACLE
- WALL MOUNTED RECEPTACLE 15A-125V HUBBELL #5262
- DUPLX RECEPTACLE MOUNTED ON WIREMOLD HUBBELL #5262.
- KEY-SWITCH CONTROLLED DUPLX RECEPTACLE MOUNTED ON WIREMOLD. HUBBELL #5262.

LIGHTING PLAN  
SCALE: 1/4"=1'-0"

LEGEND (CONT'D)

- KEY-SWITCH CONTROLLED DUPLX RECEPTACLE - 15A-125V HUBBELL #5262
- OPENING IN RAISED FLOOR FOR WIRING TO TRADING DESKS
- FLOOR MOUNTED DUPLX RECEPTACLE SPLIT-WIRED FOR (2) 20A-125V CIRCUITS HUBBELL #5582. CONNECT TO FLOOR CELL WITH COT & AFTERSET FITTING. (SEE NOTE #1 FOR AFTERSET FITTING)
- FLOOR MTD COMBINATION TEL/DUPLX RECEPTACLE TO BE REMOVED. REMOVE AFTERSET FITTING AND PLUG SLAB.
- PLUGMOLD, SIZE AS INDICATED, LENGTH AS INDICATED, WITH SINGLE RECEPTS 15A-125V SPACED AS INDICATED.
- WALL MOUNTED TELEPHONE OUTLET - CONNECT TO FLOOR CELL WITH CONDUIT AND AFTERSET FITTING (SEE NOTE #1 FOR AFTERSET FITTING)
- TELEPHONE JACK MOUNTED TO UNDERSIDE OF TRADING DESK - PROVIDED & INSTALLED BY I.P.C.
- 40 LINE TELEPHONE TURRET BUILT INTO TRADING DESK I.P.C. MODULAR SERIES X
- CEILING EXHAUST FAN
- WALL SWITCH W/ PLUG LT FOR CEF

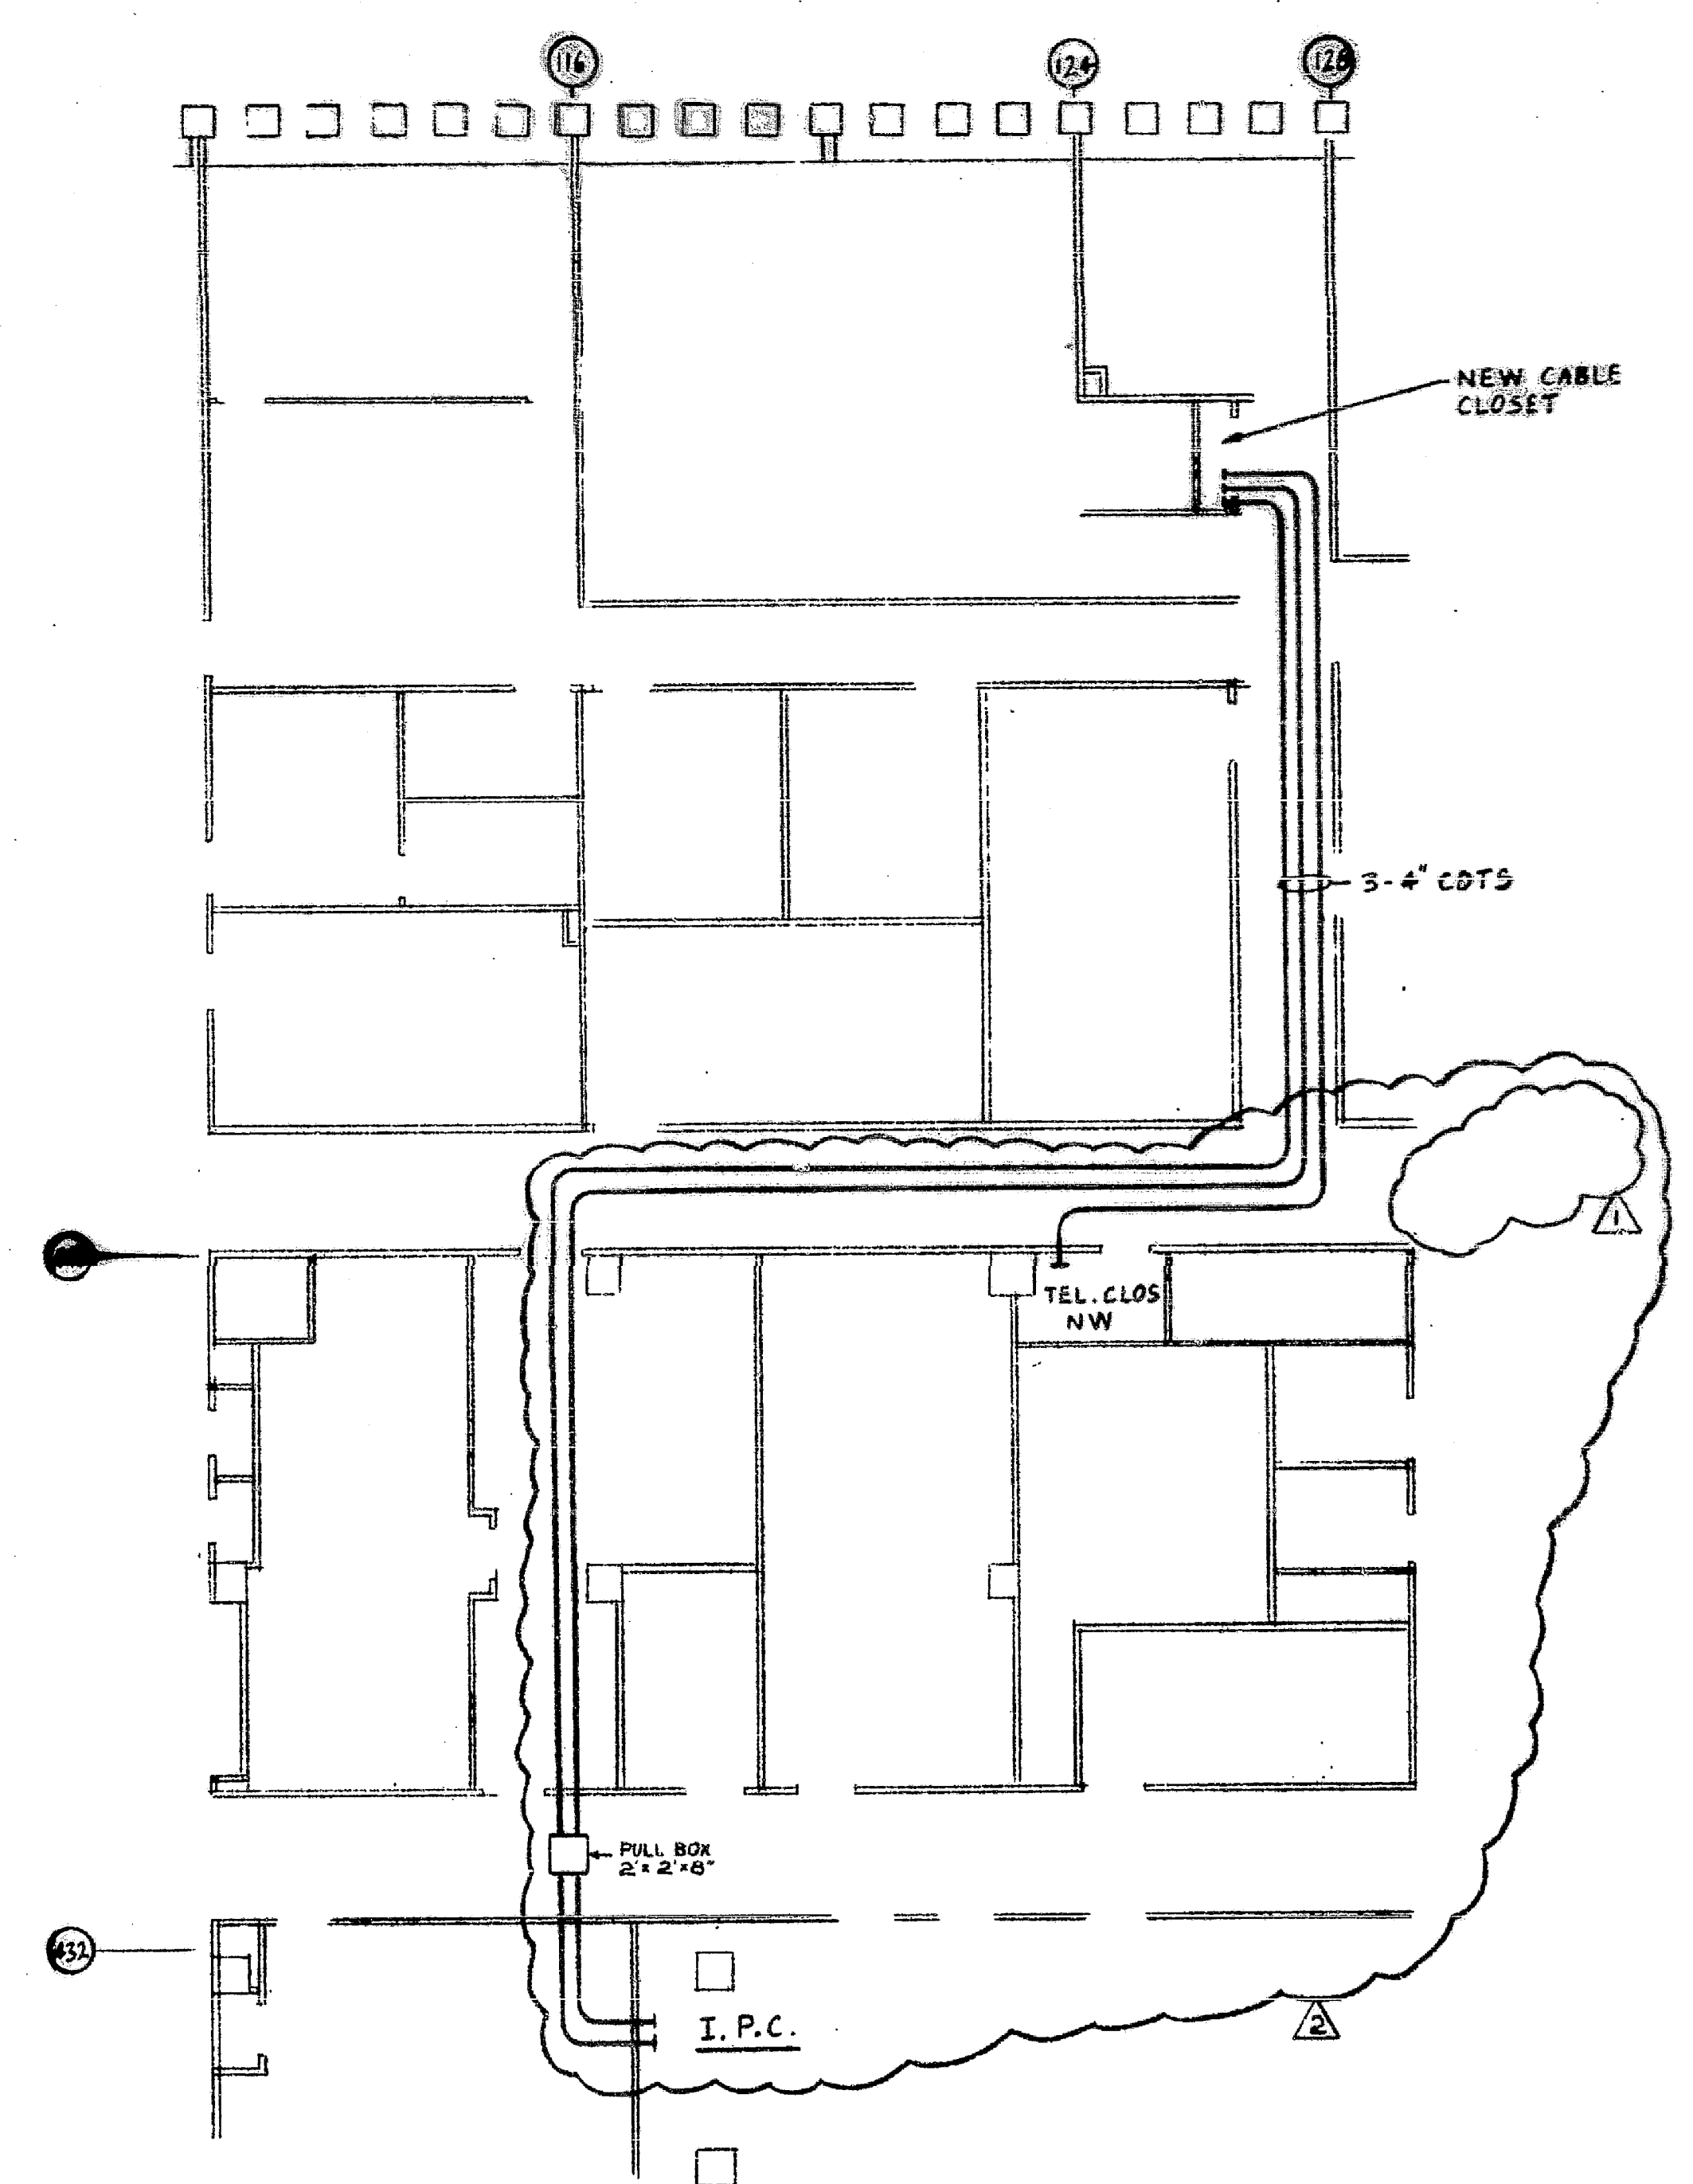

PLAN - TELEPHONE CONDUIT RUNS  
SCALE: 1/8"=1'-0"

AS-BUILT DRAWING

DATE 5/22/86  
INSPECTOR [Signature]

REV 2	5-3-88	AS PER FIELD CONDITIONS
REV 1	1-16-88	AS PER P.A. COMMENTS
CANTOR FITZGERALD SECURITIES CORP ONE WORLD TRADE CENTER FLOOR 105 NEW YORK, N.Y. 10048		
LIGHTING PLAN		
JOHN C. WESTRICK & ASSOCIATES CONSULTING ENGINEERS 2110 MAPLE AVENUE SOUTH PLAINFIELD, N.J. 07080		
JOS # 84-47	SCALE: AS SHOWN	
CHK BY: J.C.W.	DATE: 12-8-84	

